


WORK \GEC\9541\TSK4\1995ENGR\REPORT



April 96

LEGEND

- = LANDFILL ACCESS ROAD
- = OLD PROPERTY LINE
- = NEW PROPERTY LINE
- = DEC. 7, 1995 AERIAL SURVEY CONTOURS
- = PERMIT CONTOURS
- = PROPOSED MODIFICATION CONTOUR
- = STORMWATER SHEETFLOW
- = DRAINAGE PATHWAY
- = MONITORING WELL
- = RIP-RAP AREA
- = SPOT ELEVATION

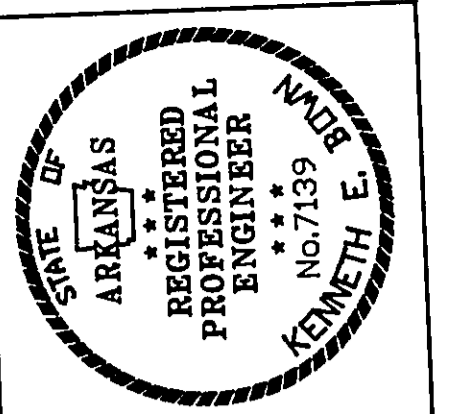

Design by: KEB  
 Checked by: BE  
 Drawn by: JFH  
 Project No.: 9541-1  
 Date: APR 29, 1996  
 Scale: 1"=100'


DRAWING 1 OF 2  
 SITE 3 MODIFICATION  
 PERMIT CONTOURS AND  
 PROPOSED CONTOURS  
 TONTITOWN, ARKANSAS

SUNRAY SERVICES, INC.  
 105 OLD MISSOURI ROAD  
 SPRINGDALE, ARKANSAS 72765  
 (501) 361-2926

GENESIS  
 ENVIRONMENTAL CONSULTING, INC.  
 8211 Geyer Springs Road  
 Little Rock, AR 72209

Approved by	Solid Waste Division
Date Rec'd	Drawing # 286
Permit #	CSN 72-0144
Engr	Geol
<input type="checkbox"/> Design Drawing	<input type="checkbox"/> Permit Plan
<input type="checkbox"/> GWT Plan	<input type="checkbox"/> Construction
<input type="checkbox"/> Other	
Supercedes Drawing #	
Superceded by Drawing #	
Superceded on Date	

# SITE 3

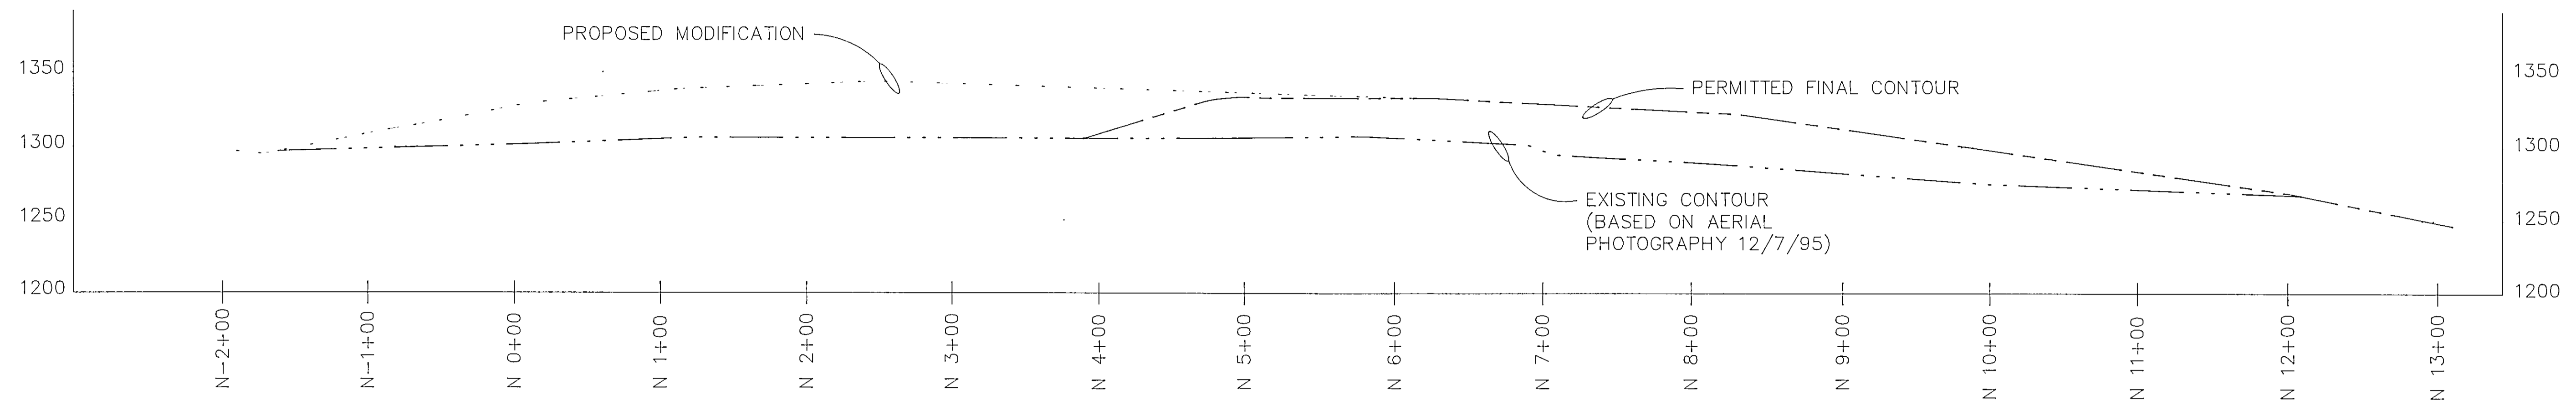


## SECTION A-A STATION 1000 E

SCALE: VERTICAL - 1"=60'  
HORIZONTAL - 1"=60'

# SITE 4

# SITE 3

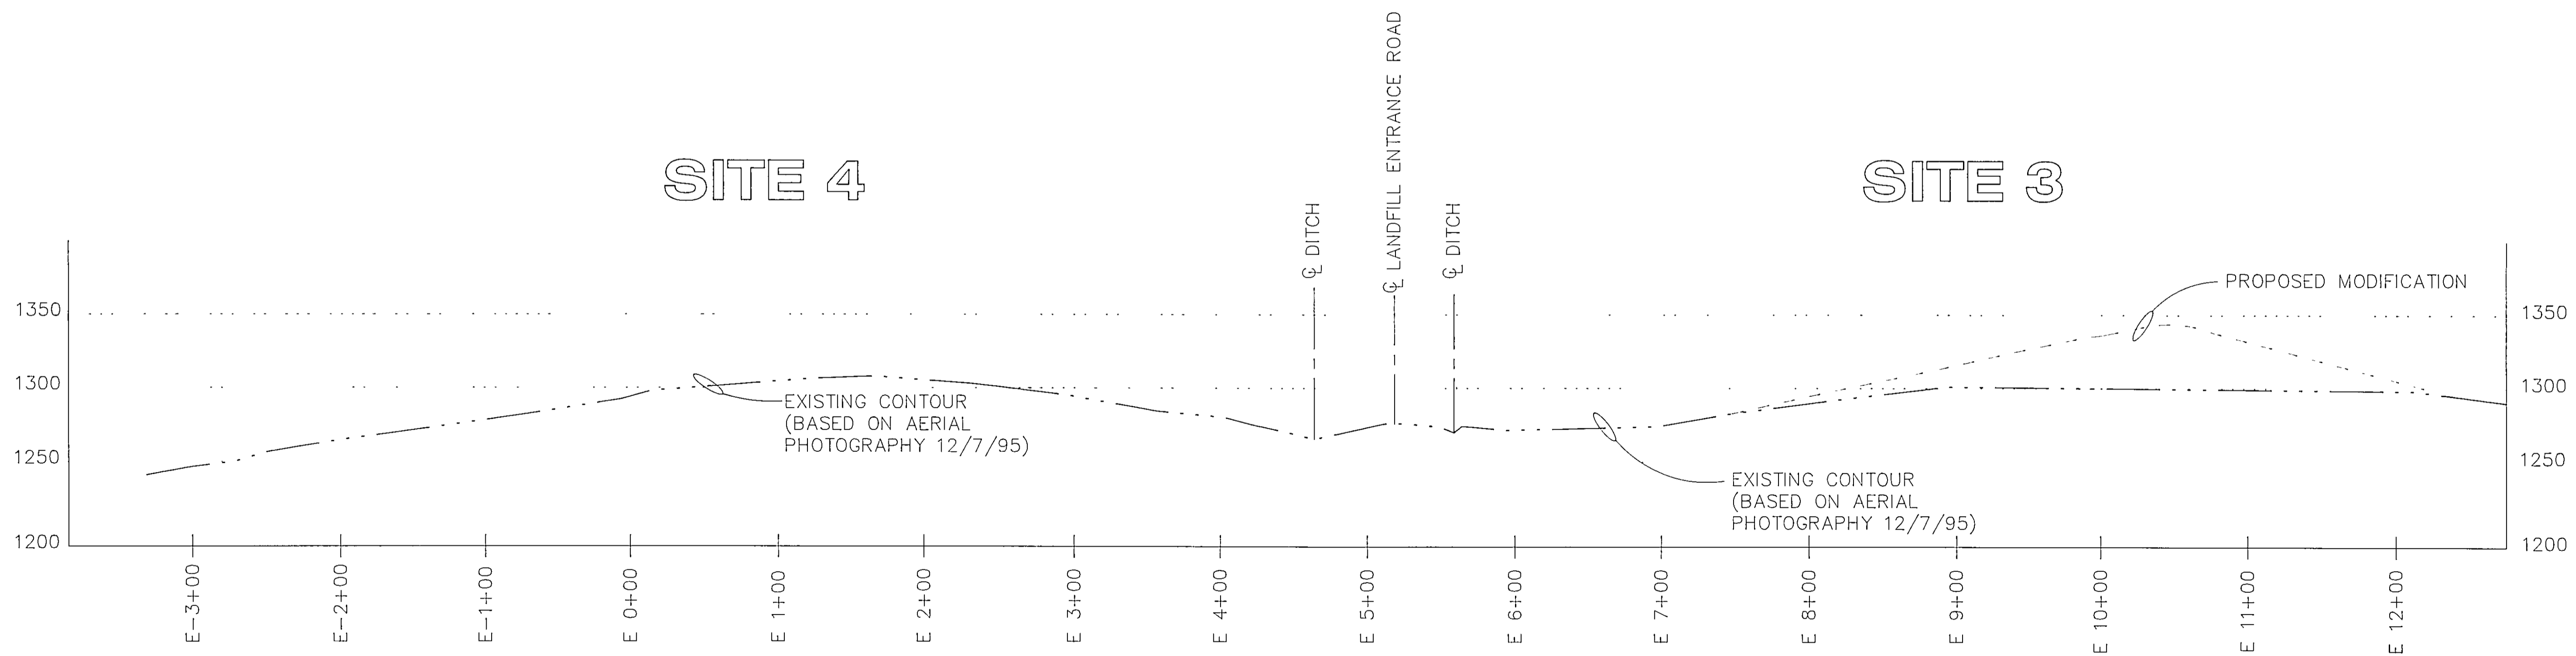

## SECTION B-B STATION 300 N


SCALE: VERTICAL - 1"=60'  
HORIZONTAL - 1"=60'


**GEC** // GENESIS ENVIRONMENTAL CONSULTING, INC.  
8211 Geyer Springs Road  
Little Rock, AR 72209

**SUNRAY SERVICES, INC.**  
105 OLD MISSOURI ROAD  
SPRINGDALE, ARKANSAS 72765  
(501) 361-2926

**DRAWING 2 OF 2**  
SITE 3 MODIFICATION  
CROSS SECTIONS OF PERMIT  
CONTOURS & PROPOSED CONTOURS  
TONTITOWN, ARKANSAS

Design by:	KEB
Checked by:	BE
Drawn by:	JFH
Project No.:	9541-11
Date:	APR 29, 1996
Scale:	AS SHOWN

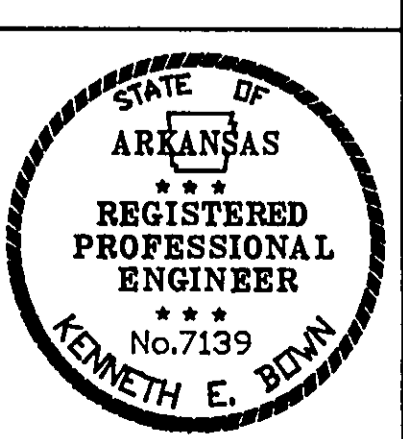

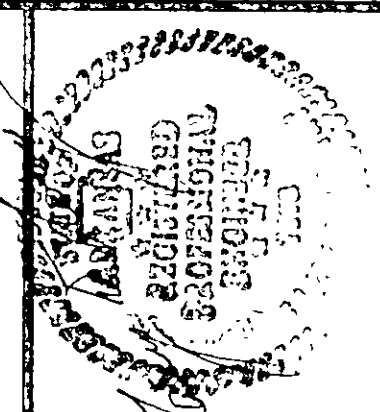


REV.	DATE	DESCRIPTION	CK. BY
1	12/20/91	CURRENT ELL AREAS	GC
2	1/28/92	CURRENT ELL AREAS	GC
3	7/29/92	CURRENT ELL AREAS	GC
4	12/21/92	CURRENT AND PROPOSED ELL AREAS	GC
5	5/5/93	CURRENT AND PROPOSED ELL AREAS	GC

SHEET TITLE: CURRENT FILL AREA  
 PROJECT TITLE: SUNRAY SERVICES INC. SITE 4  
 TONTITOWN, ARKANSAS

CLIENT: SUNRAY SERVICES, INC.  
 105 OLD MISSOURI ROAD  
 SPRINGDALE, ARKANSAS 72765  
 (501) 361-2926

SCS ENGINEERS  
 STEARNS, CONRAD AND SCHMIDT  
 CONSULTING ENGINEERS  
 1015 W. 17TH ST. SUITE 200  
 SPRINGDALE, ARKANSAS 72765  
 PH: (501) 361-2926 FAX: (501) 361-2925  
 PROJECT NO.: 02-89015.11  
 DATE: 5/5/93  
 DRAWN BY: JOW  
 CHECKED BY: JOW  
 APPROVED BY: JOW

CADD FILE: SCSMAY1  
 DATE: MAY 1993  
 SCALE: 1" = 100'-0"  
 DRAWING NO.

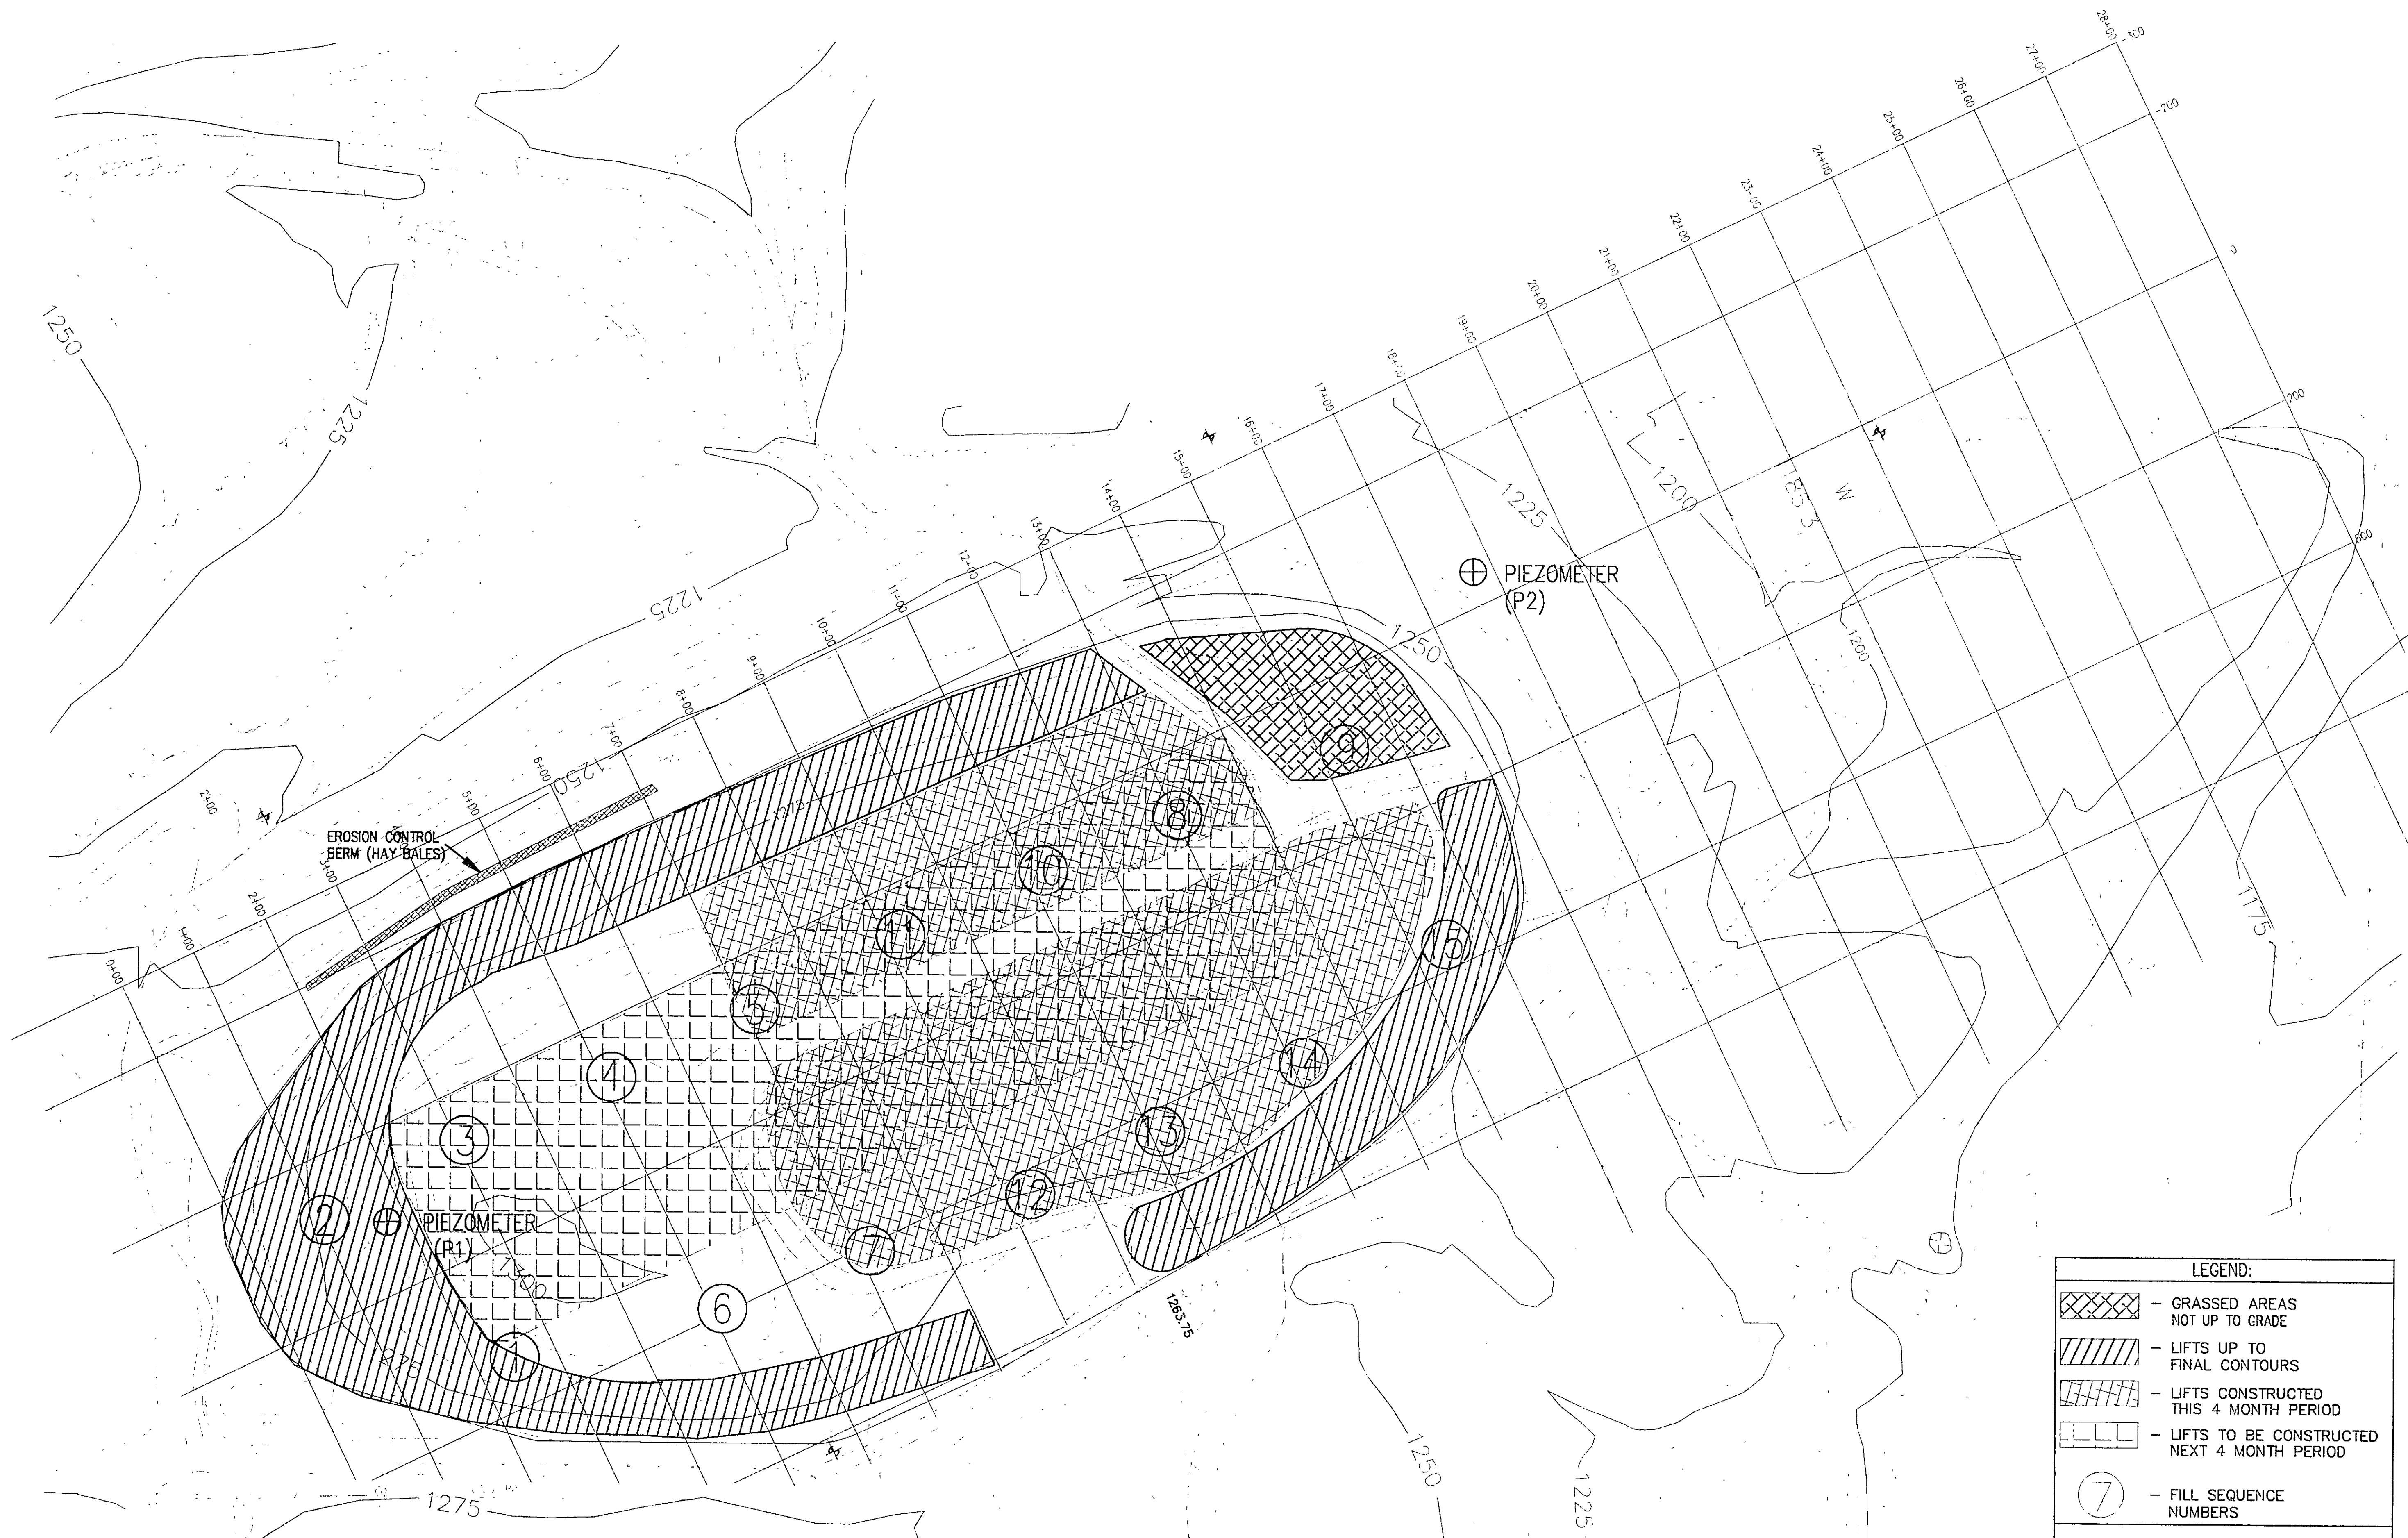

LEGEND:

	- GRASSED AREAS NOT UP TO GRADE
	- LIFTS UP TO FINAL CONTOURS
	- LIFTS CONSTRUCTED THIS 4 MONTH PERIOD
	- LIFTS TO BE CONSTRUCTED NEXT 4 MONTH PERIOD
	- FILL SEQUENCE NUMBERS

NOTES:

EXISTING CONTOURS FROM AERIAL PHOTO 27/NOV/92 BY AMI ENGINEERING, INC., MODIFIED 5/5/93.  
 5' CONTOUR INTERVAL  
 THE SITE HAS HAD LIME APPLIED IN PREPARATION FOR THE SPRING SEEDING PLAN WHICH COMMENCES THIS MONTH.

ADEQ Solid Waste Division

Date Rec'd \_\_\_\_\_ Drawing # 281-33  
 Permit # \_\_\_\_\_ CSN 72-0144  
 Engr \_\_\_\_\_ Geol \_\_\_\_\_  
 Design Drawing  Permit Plan  
 GWM Plan  Construction  
 Other \_\_\_\_\_  
 Supersedes Drawing # \_\_\_\_\_  
 Superseded by Drawing # \_\_\_\_\_  
 Superseded on Date \_\_\_\_\_

SCSMAY1 1:00 5/5/93

SCSMAY2 1"=100 5/27/93



REV.	DATE	DESCRIPTION	CK. BY	BY
1	12/29/91	AS BUILT CONTOURS	GC	GC
2	2/1/92	AS BUILT CONTOURS	GC	GC
3	12/21/92	AS BUILT CONTOURS	GC	GC
4	5/6/93	AS BUILT CONTOURS	GC	GH

SHEET TITLE: AS BUILT CONTOURS VERSUS APPROVED SEPTEMBER 1991 MODIFICATION CONTOURS  
 PROJECT TITLE: SUNRAY SERVICES INC. SITE 4 TONTITOWN, ARKANSAS

CLIENT: SUNRAY SERVICES, INC.  
 105 OLD MISSOURI ROAD  
 SPRINGDALE, ARKANSAS 72765  
 (501) 361-2926

SCS ENGINEERS  
 STEARNS, CONRAD AND SCHMIDT  
 CONSULTING ENGINEERS  
 15401 HOLMES ROAD, SUITE 400, KANSAS CITY, MISSOURI 64147  
 PH. (816) 847-7650 FAX NO. (816) 841-8025  
 REG. NO. 08-89016.11  
 EXPI. DATE: 12/31/93  
 SEAL NO. 1275  
 SEAL DATE: 5/27/93

CADD FILE: SCSMAY2  
 DATE: MAY 1993  
 SCALE: 1" = 100'  
 DRAWING NO. 2 of 2